


[OCT 1919?]

House ~~B.~~ B. - or C
as seems best

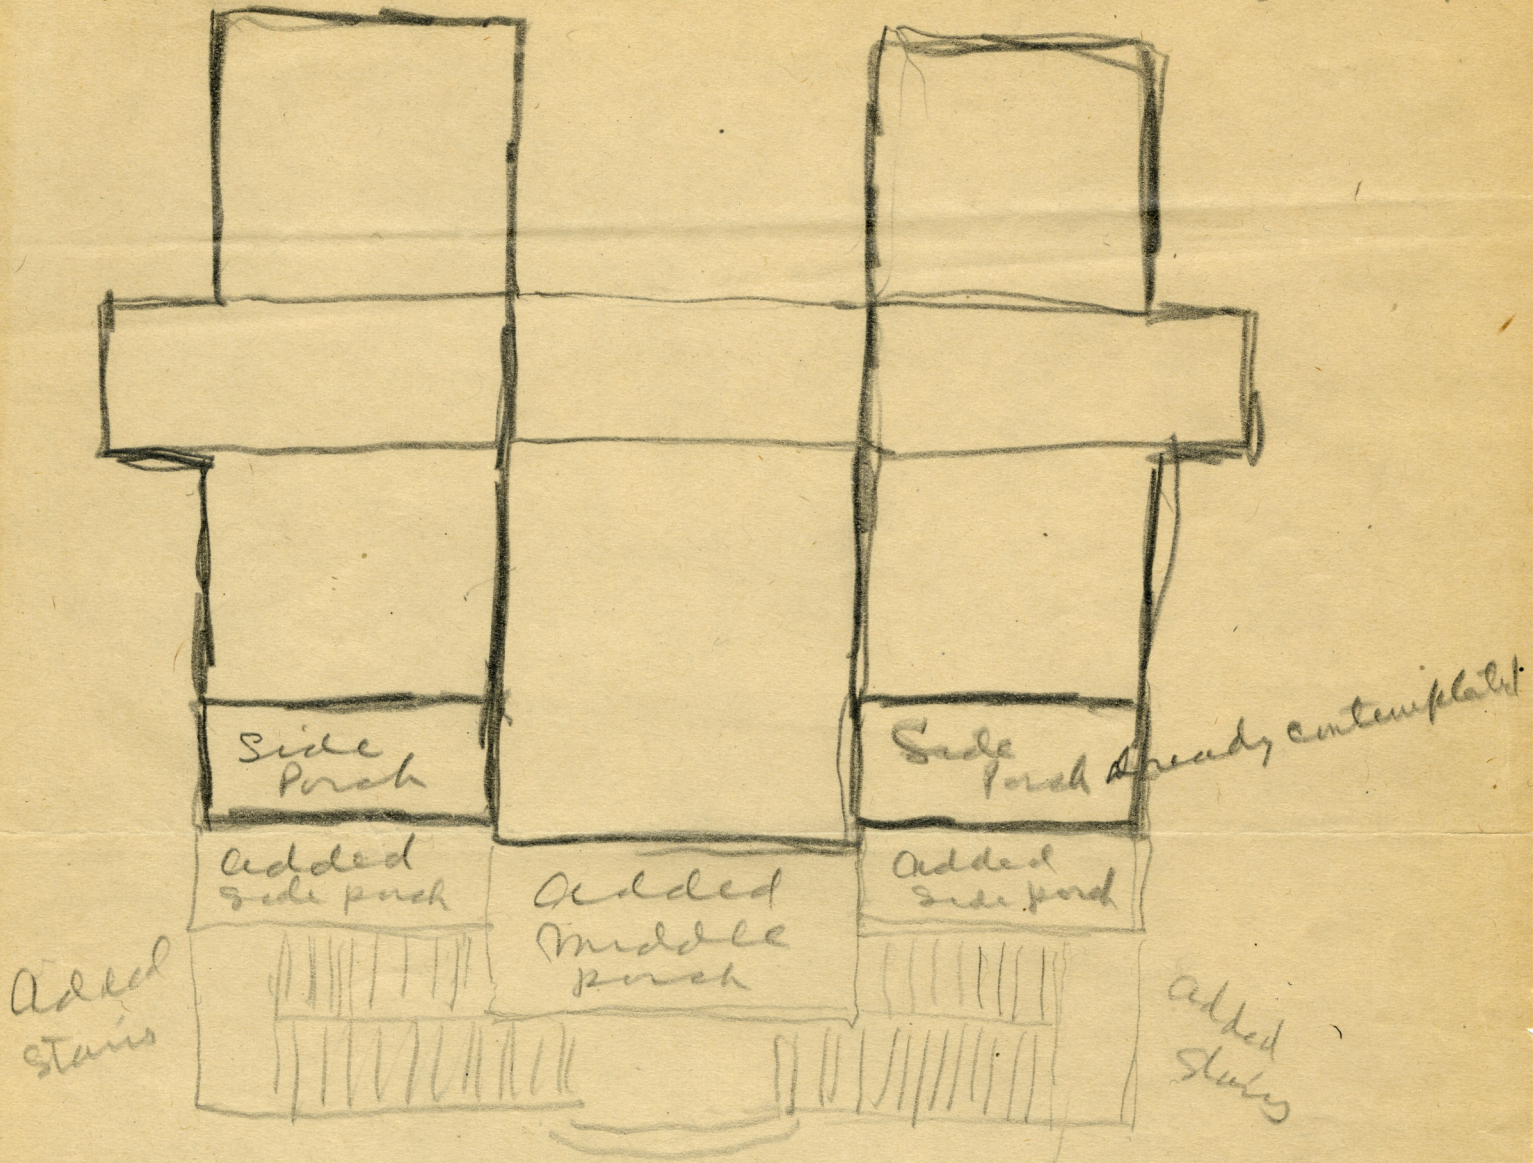


Black line shows house as originally drawn. Light lines show the additions I propose. There need be no change in bedrooms or parlor or any part of house proper. There are

merely additions of porches
and stairs on the view side.

The porch before the sitting room
or parlor is entirely new. The
porches in front of bed rooms are
there in part already but are
made deeper to reach to about
the middle of the central porch.

The stairs are added in entirety
but all of this is outside construction
and only on one end of the
building. There need be
no loggias on this scheme
and so the roof plans need
not be affected, but if you
want loggias on this plan I think
they would be better over the side
porches for a change, leaving the
middle porch open. WRS

Outside addition to house C. — or B
if this should suit B better then use other one for
C.

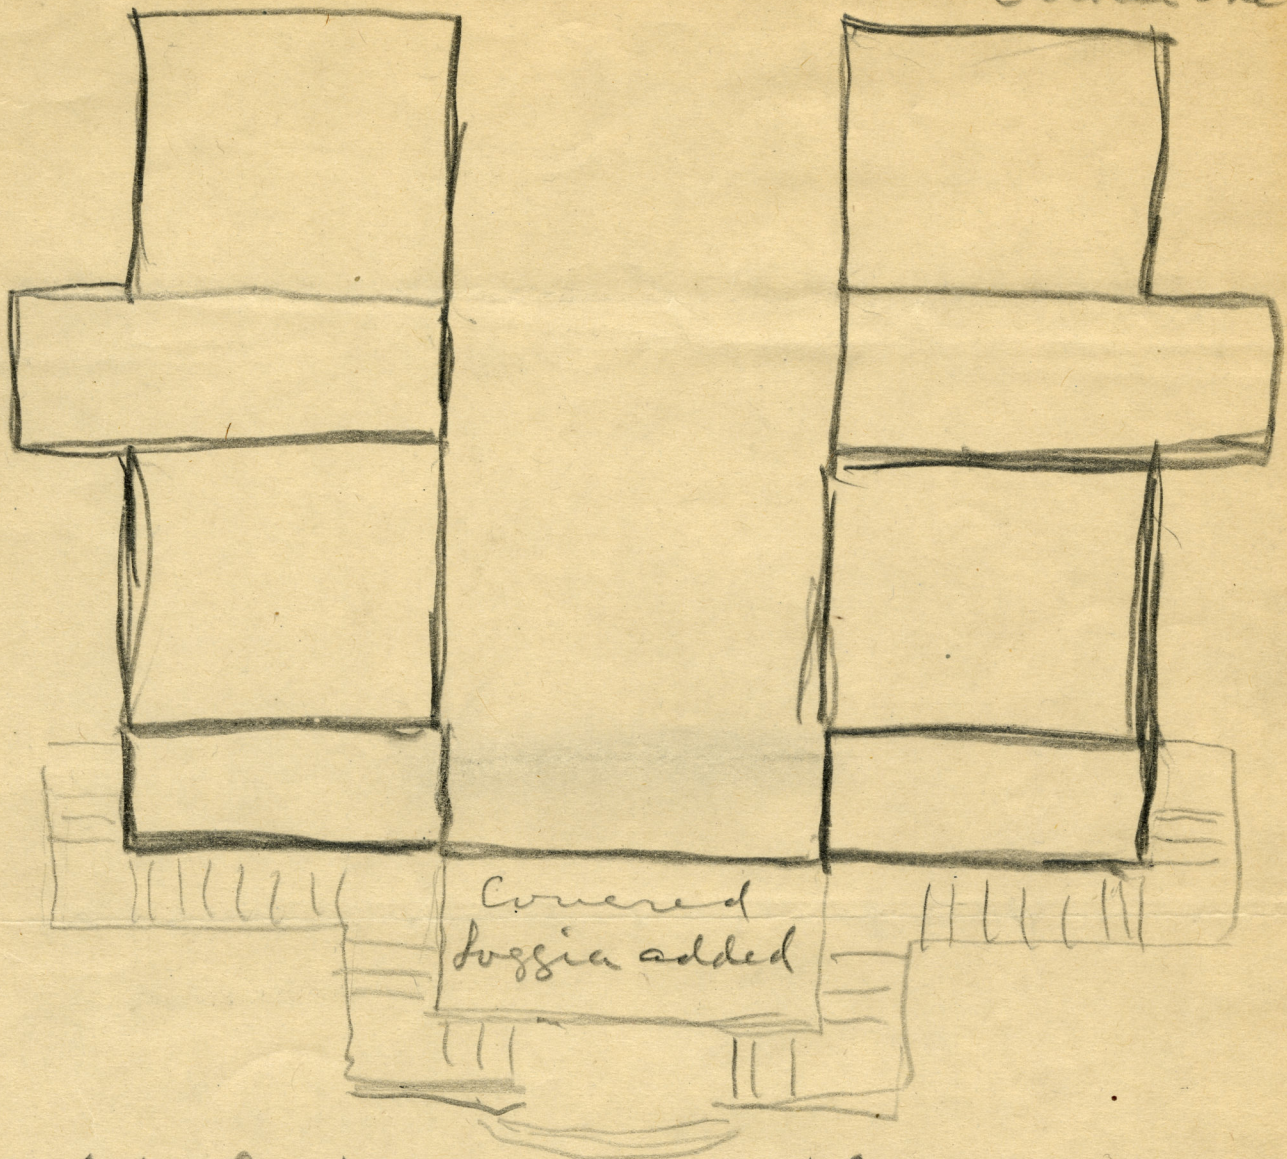

Light lines show the covered
loggia and the stairs added
to the view side of the house
It is all outside construction
except that the covered loggia
will require an altered roof
plan tracing for which I have
already sent in previous note.

I suggested in previous note that if we had not started to build yet we could lengthen the house thus making little deeper court, longer bed rooms and more spacious parlor but this need not be considered as difficult to accomplish or if we have already begun to erect walls.

The additions advised in this present letter are all outside additions and can be added to the houses if even if they were finished.

I think covered center loggia would be ~~the~~ better for house C and the other plan for B but if the ground conditions required they could be interchanged Sincerely W R Hunt